


S. 41 405
 32 396
 37

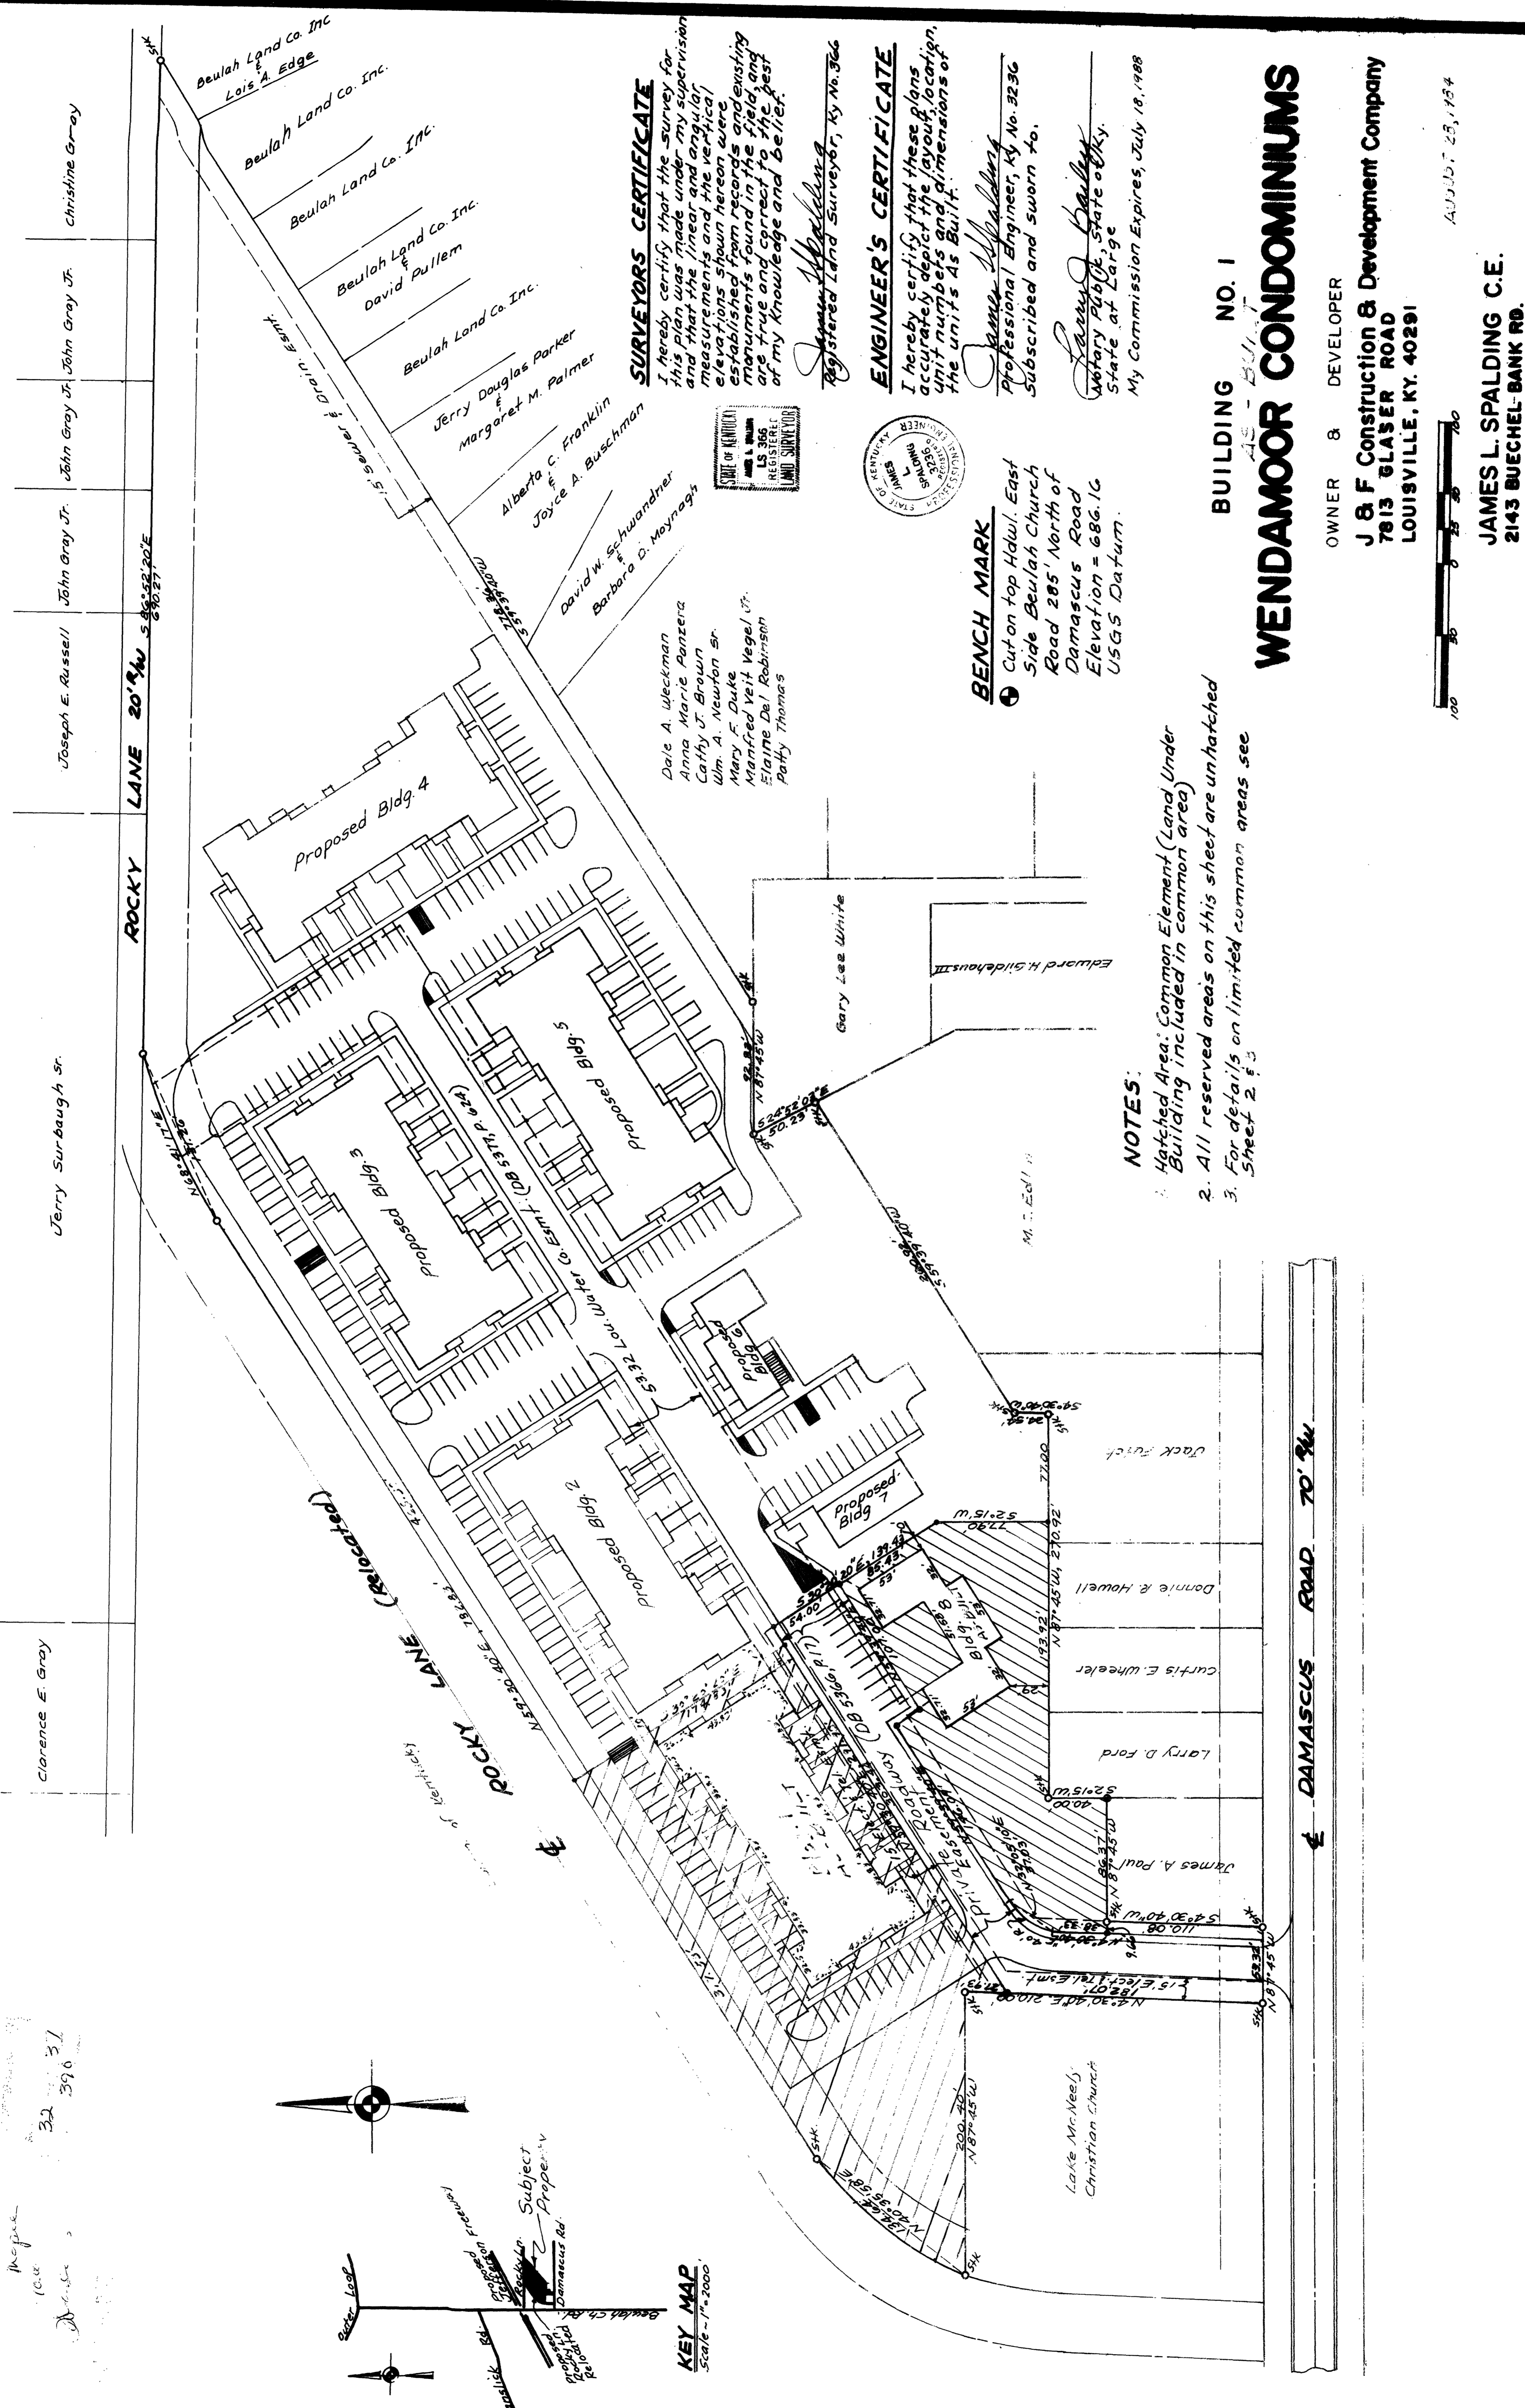

Clarence E. Gray
 Joseph E. Russell
 John Gray Jr.
 John Gray Jr.
 John Gray Jr.
 Christine Gray

ROCKY LANE
 LANE 20' RW
 58°52'22"E
 68°37'37"

Beulah Land Co. Inc.
 Lois A. Edge
 Beulah Land Co. Inc.
 Beulah Land Co. Inc.
 David Pullen
 Beulah Land Co. Inc.
 Jerry Douglas Parker
 Margaret M. Palmer
 Beulah Land Co. Inc.
 Alberto C. Franklin
 Joyce A. Buschman
 David W. Schwandner
 Barbara D. Moynagh

Proposed Bldg 1
 Proposed Bldg 2
 Proposed Bldg 3
 Proposed Bldg 4
 Proposed Bldg 5
 53.32 Lot. Water Co. Smt. 1 (DB 5379.2 sq ft)
 53.32 Lot. Water Co. Smt. 2 (DB 5379.2 sq ft)
 53.32 Lot. Water Co. Smt. 3 (DB 5379.2 sq ft)
 53.32 Lot. Water Co. Smt. 4 (DB 5379.2 sq ft)
 53.32 Lot. Water Co. Smt. 5 (DB 5379.2 sq ft)

Dale A. Weckman
 Anna Marie Panzer
 Cathy J. Brown
 Wm. A. Newton Sr.
 Mary F. Duke
 Marjorie Veit Vogel, Jr.
 Elaine D. Robinson
 Patty Thomas

Gary Lee White
 Edward H. Sidehouse II
 M. Ed. II
 Donnie R. Howell
 Curtis E. Wheeler
 Larry D. Ford
 James A. Paul
 Lake McNeely
 Christian Church

ROCKY LANE (Relocated)
 53.32 Lot. Water Co. Smt. 1 (DB 5379.2 sq ft)
 53.32 Lot. Water Co. Smt. 2 (DB 5379.2 sq ft)
 53.32 Lot. Water Co. Smt. 3 (DB 5379.2 sq ft)
 53.32 Lot. Water Co. Smt. 4 (DB 5379.2 sq ft)
 53.32 Lot. Water Co. Smt. 5 (DB 5379.2 sq ft)

DAMASCUS ROAD 20' RW

SURVEYORS CERTIFICATE
 I hereby certify that the survey for this plan was made under my supervision and that the lines and angular measurements shown and the vertical elevations shown hereon were established from hereon, were compared with the field, and are true and correct to the best of my knowledge and belief.



James L. Spalding
 Registered Land Surveyor, Ky No. 366

ENGINEER'S CERTIFICATE
 I hereby certify that these plans accurately depict the layout, location, unit numbers and dimensions of the units as built.

James L. Spalding
 Professional Engineer, Ky No. 3236
 Subscribed and sworn to.

James L. Spalding
 Notary Public, State of Ky.
 State at Large
 My Commission Expires, July 18, 1988

BENCH MARK
 Cut on top Hdl. East
 Side Beulah Church
 Road 285' North of
 Damascus Road
 Elevation = 686.16
 USGS Datum.



- NOTES:**
- Hatched Area: Common Element (Land Under Building included in common area)
 - All reserved areas on this sheet are unhatched
 - For details on limited common areas see Sheet 2 of 3

BUILDING NO. 1
 AS-BUILT

WENDAMOOR CONDOMINIUMS


OWNER & DEVELOPER
J & F Construction & Development Company
 7813 GLASER ROAD
 LOUISVILLE, KY. 40291



JAMES L. SPALDING C.E.
 2143 BUECHEL-BANK RD.
 LOUISVILLE, KY. 40218

57405

WARRANTY
OR
32 390

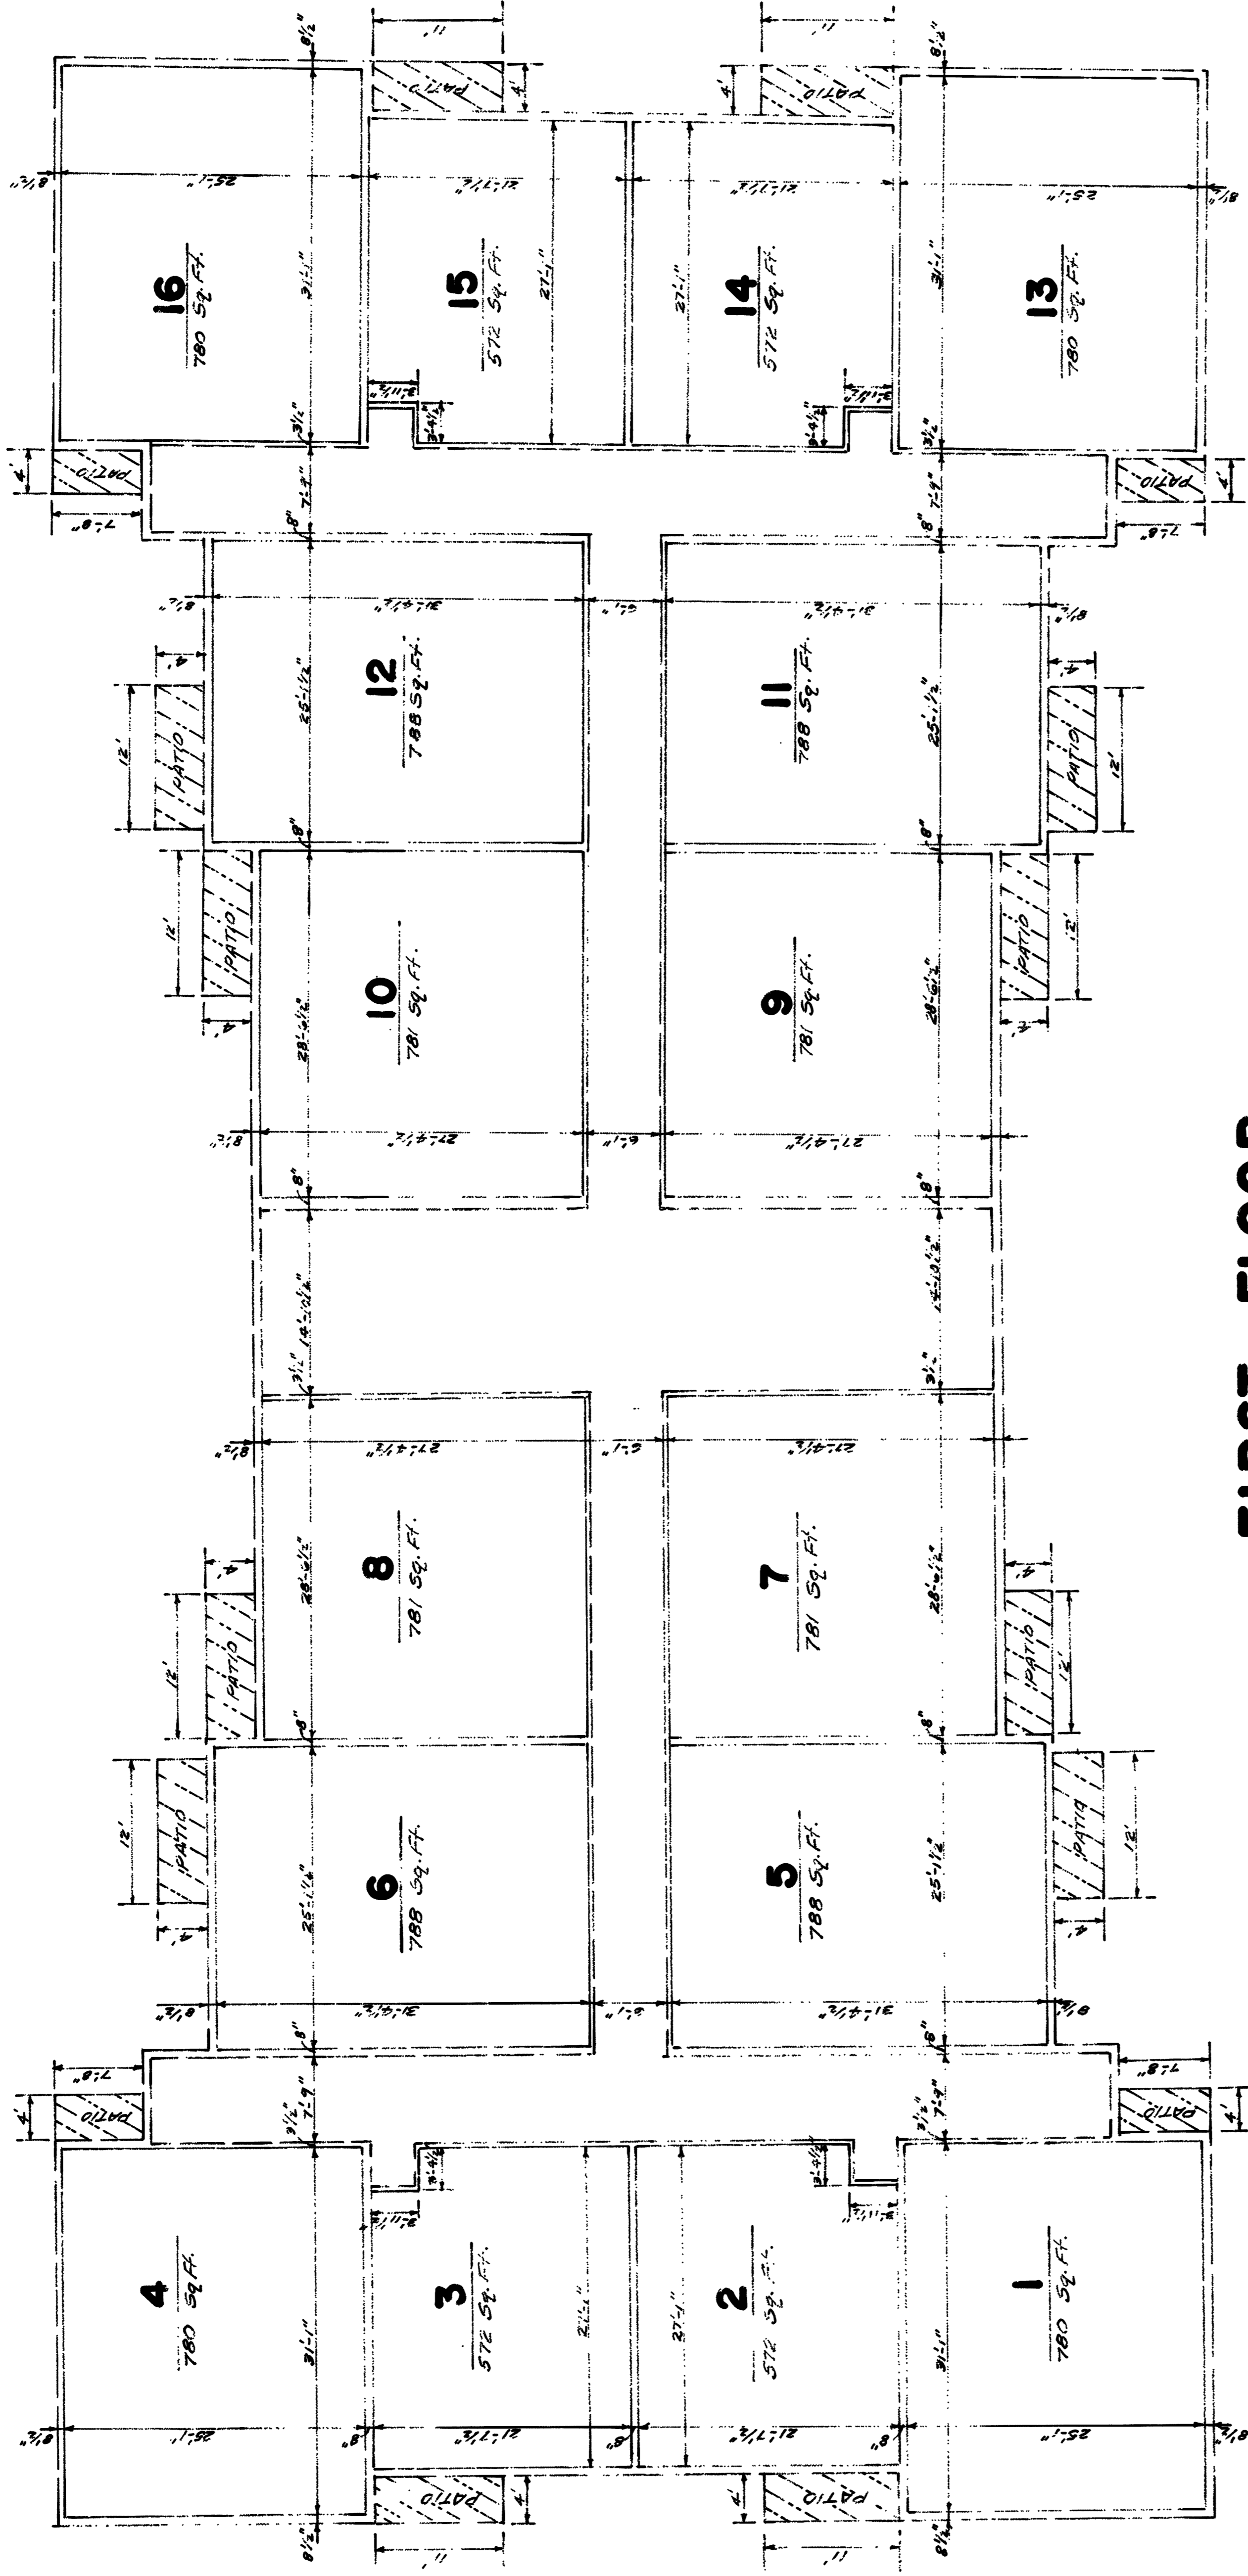

FIRST FLOOR

NOTES:

1. Each condominium unit consists of the space bounded by a vertical projection of the condominium unit boundary lines shown and by the horizontal planes at the floor and ceiling elevations; See note 5 for as-built elevations.
2. Elevations shown in feet are based upon U.S.C.S. mean sea level datum. Bench Mark, floor and ceiling elevations are referred to this datum.
3. All interior angles of condominium units are 90°
4. Legend
 - Boundary of Condominium Units
 - Indicates Common elements
 - /// Indicates Limited common area


5. Condominium units have the following Elevations:

Unit No.	1st Floor Elev.	Ceiling Elev.
1	G.F.F.F.	700.43
2	"	"
3	"	"
BUILDING NO. 1
AS-BUILT

WENDAMOOR CONDOMINIUMS


OWNER & DEVELOPER
 J & F Construction & Development Company
 7813 Glaser Road
 Lou., Ky. 40291

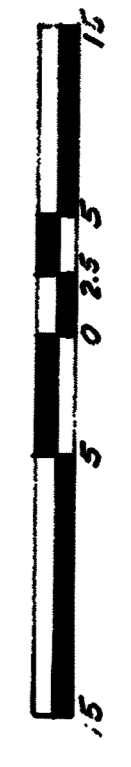

AUGUST 28, 1984

JAMES L. SPALDING C.E.
 2143 BUECHEL BANK RD.
 LOUISVILLE, KY. 40218

59465
Naple
100
31
310
Abundance

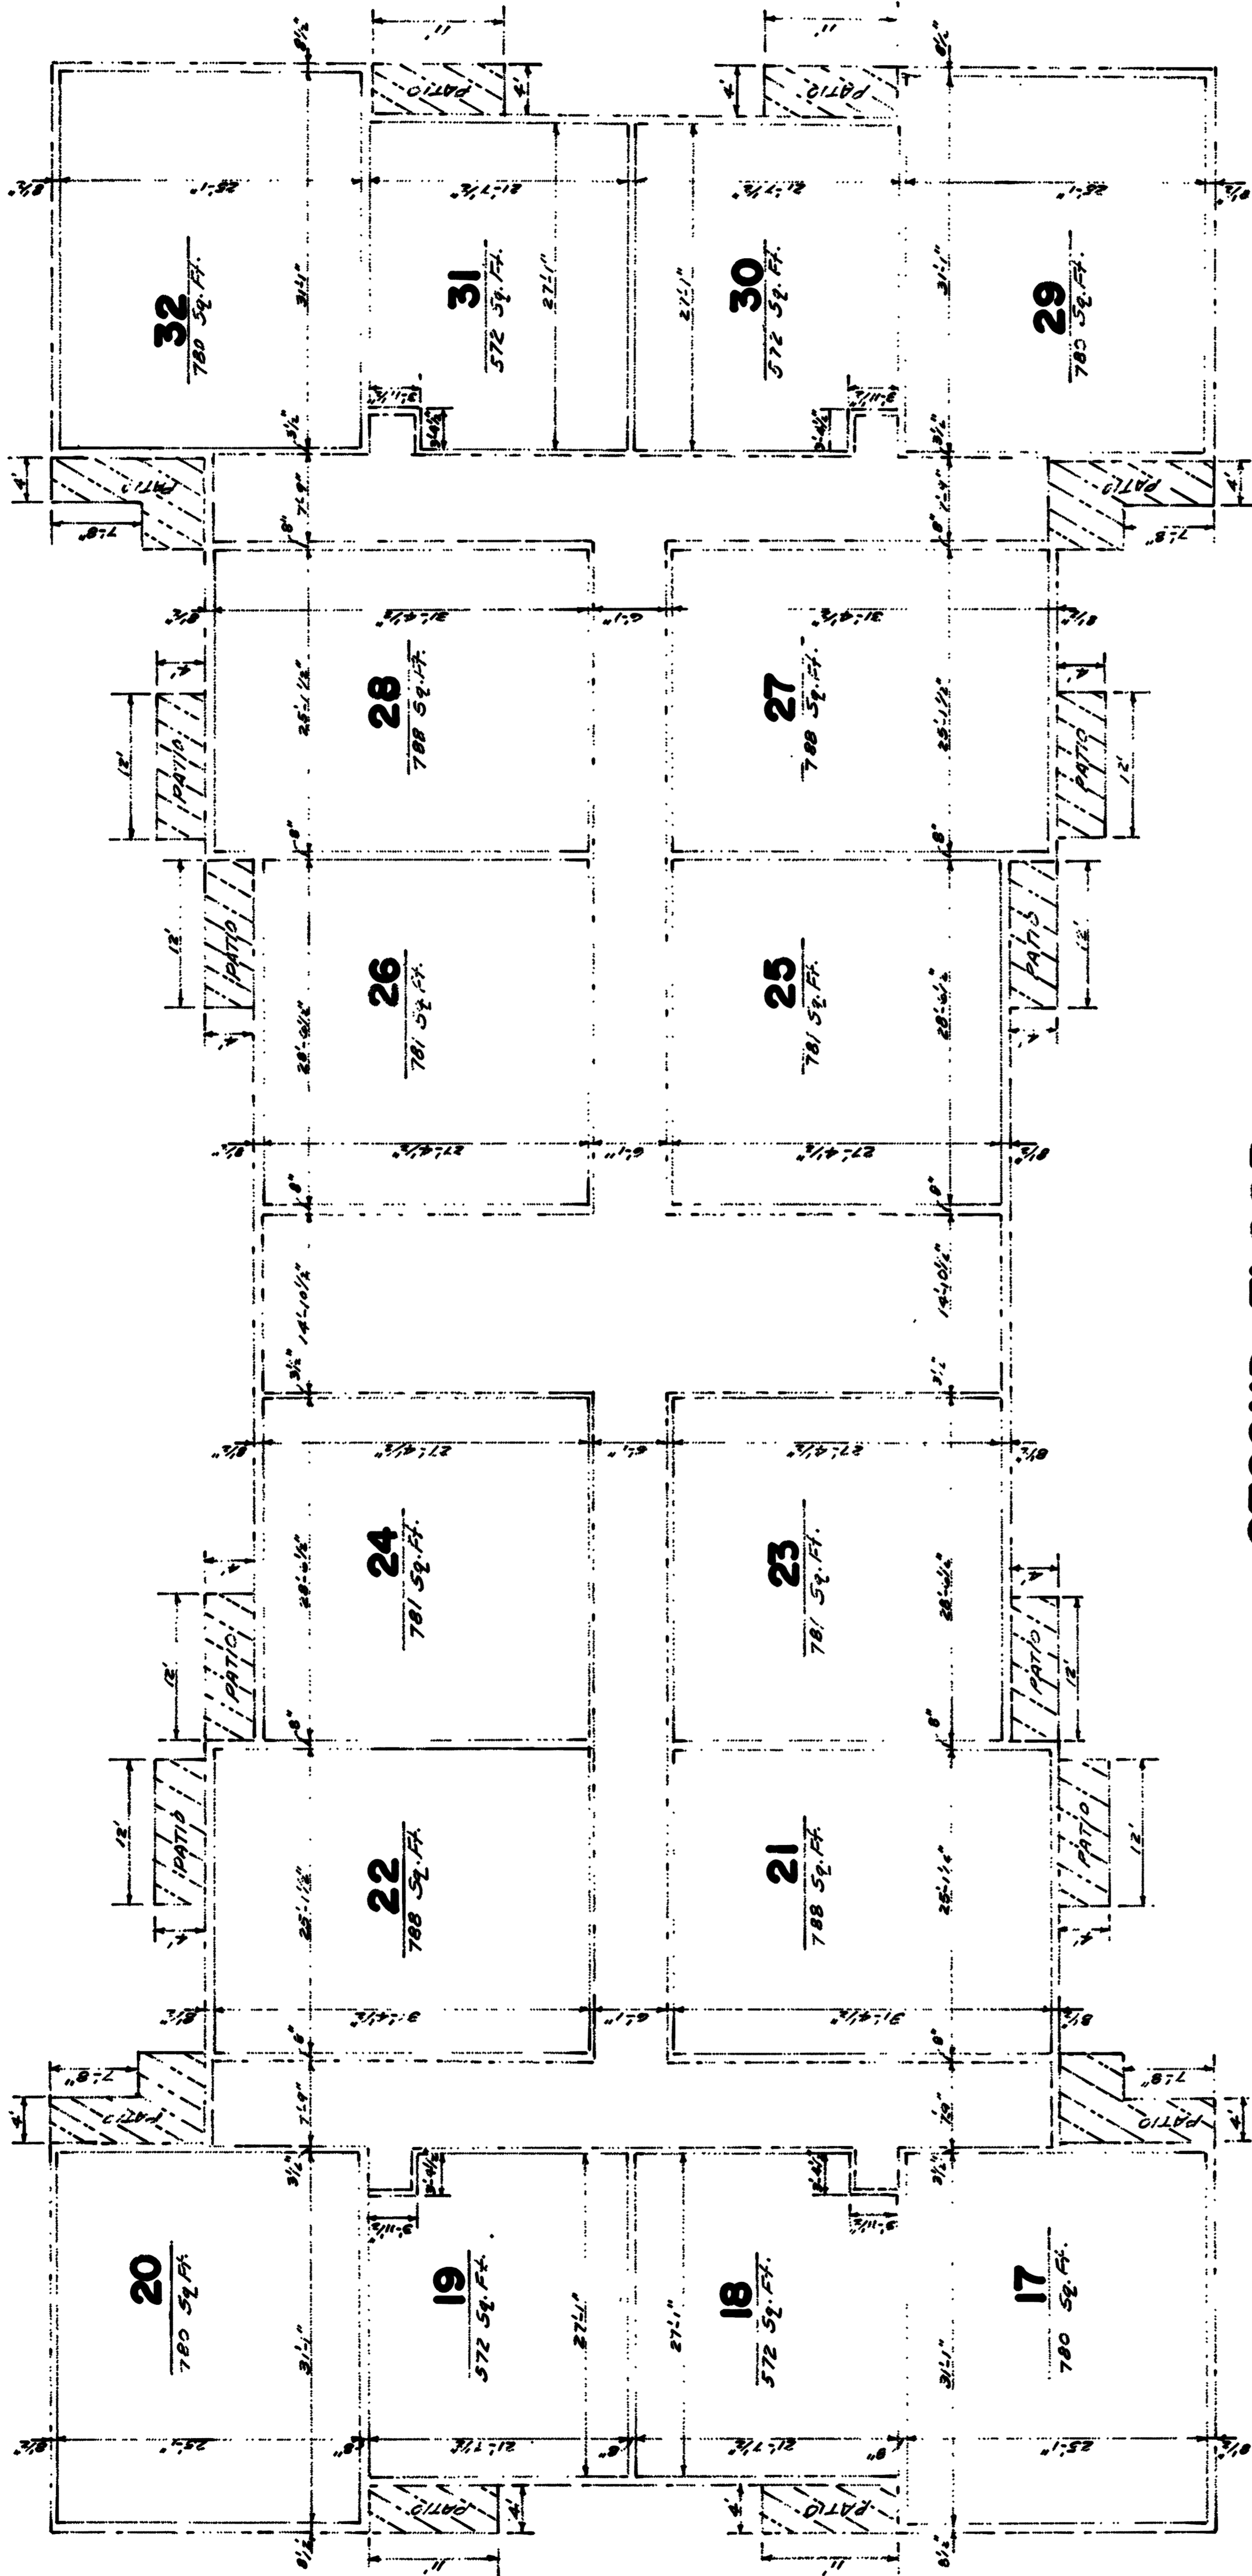

SECOND FLOOR

NOTES:

1. Each condominium unit consists of the space bounded by a vertical projection of the condominium unit boundary lines shown and by the horizontal planes of the floor and ceiling elevations; see note 5 for as-built elevations.
2. Elevations shown in feet are based upon U.S. M.S. mean sea level datum. Bench mark, floor and ceiling elevations are referred to this datum.
3. All interior angles of condominium units are 90°.
4. Legend
 - Boundary of Condominium Units
 - Indicates Common elements.
 - ////// Indicates Limited Common area

5. Condominium units have the following Elevations:

Unit No.	2nd Floor Elev.	Ceiling Elev.
17	701.42	709.50
18	"	"
19	"	"
BUILDING NO. 1
AS-BUILT

WENDAMOOR CONDOMINIUMS

OWNER & DEVELOPER
J & F Construction & Development Company
7813 Glaser Road
Lou., Ky. 40291



AUGUST 28, 1984

JAMES L. SPALDING C.E.
2143 BUECHEL BANK RD.
LOUISVILLE, KY. 40218