


75437
Maple
No.
Dance

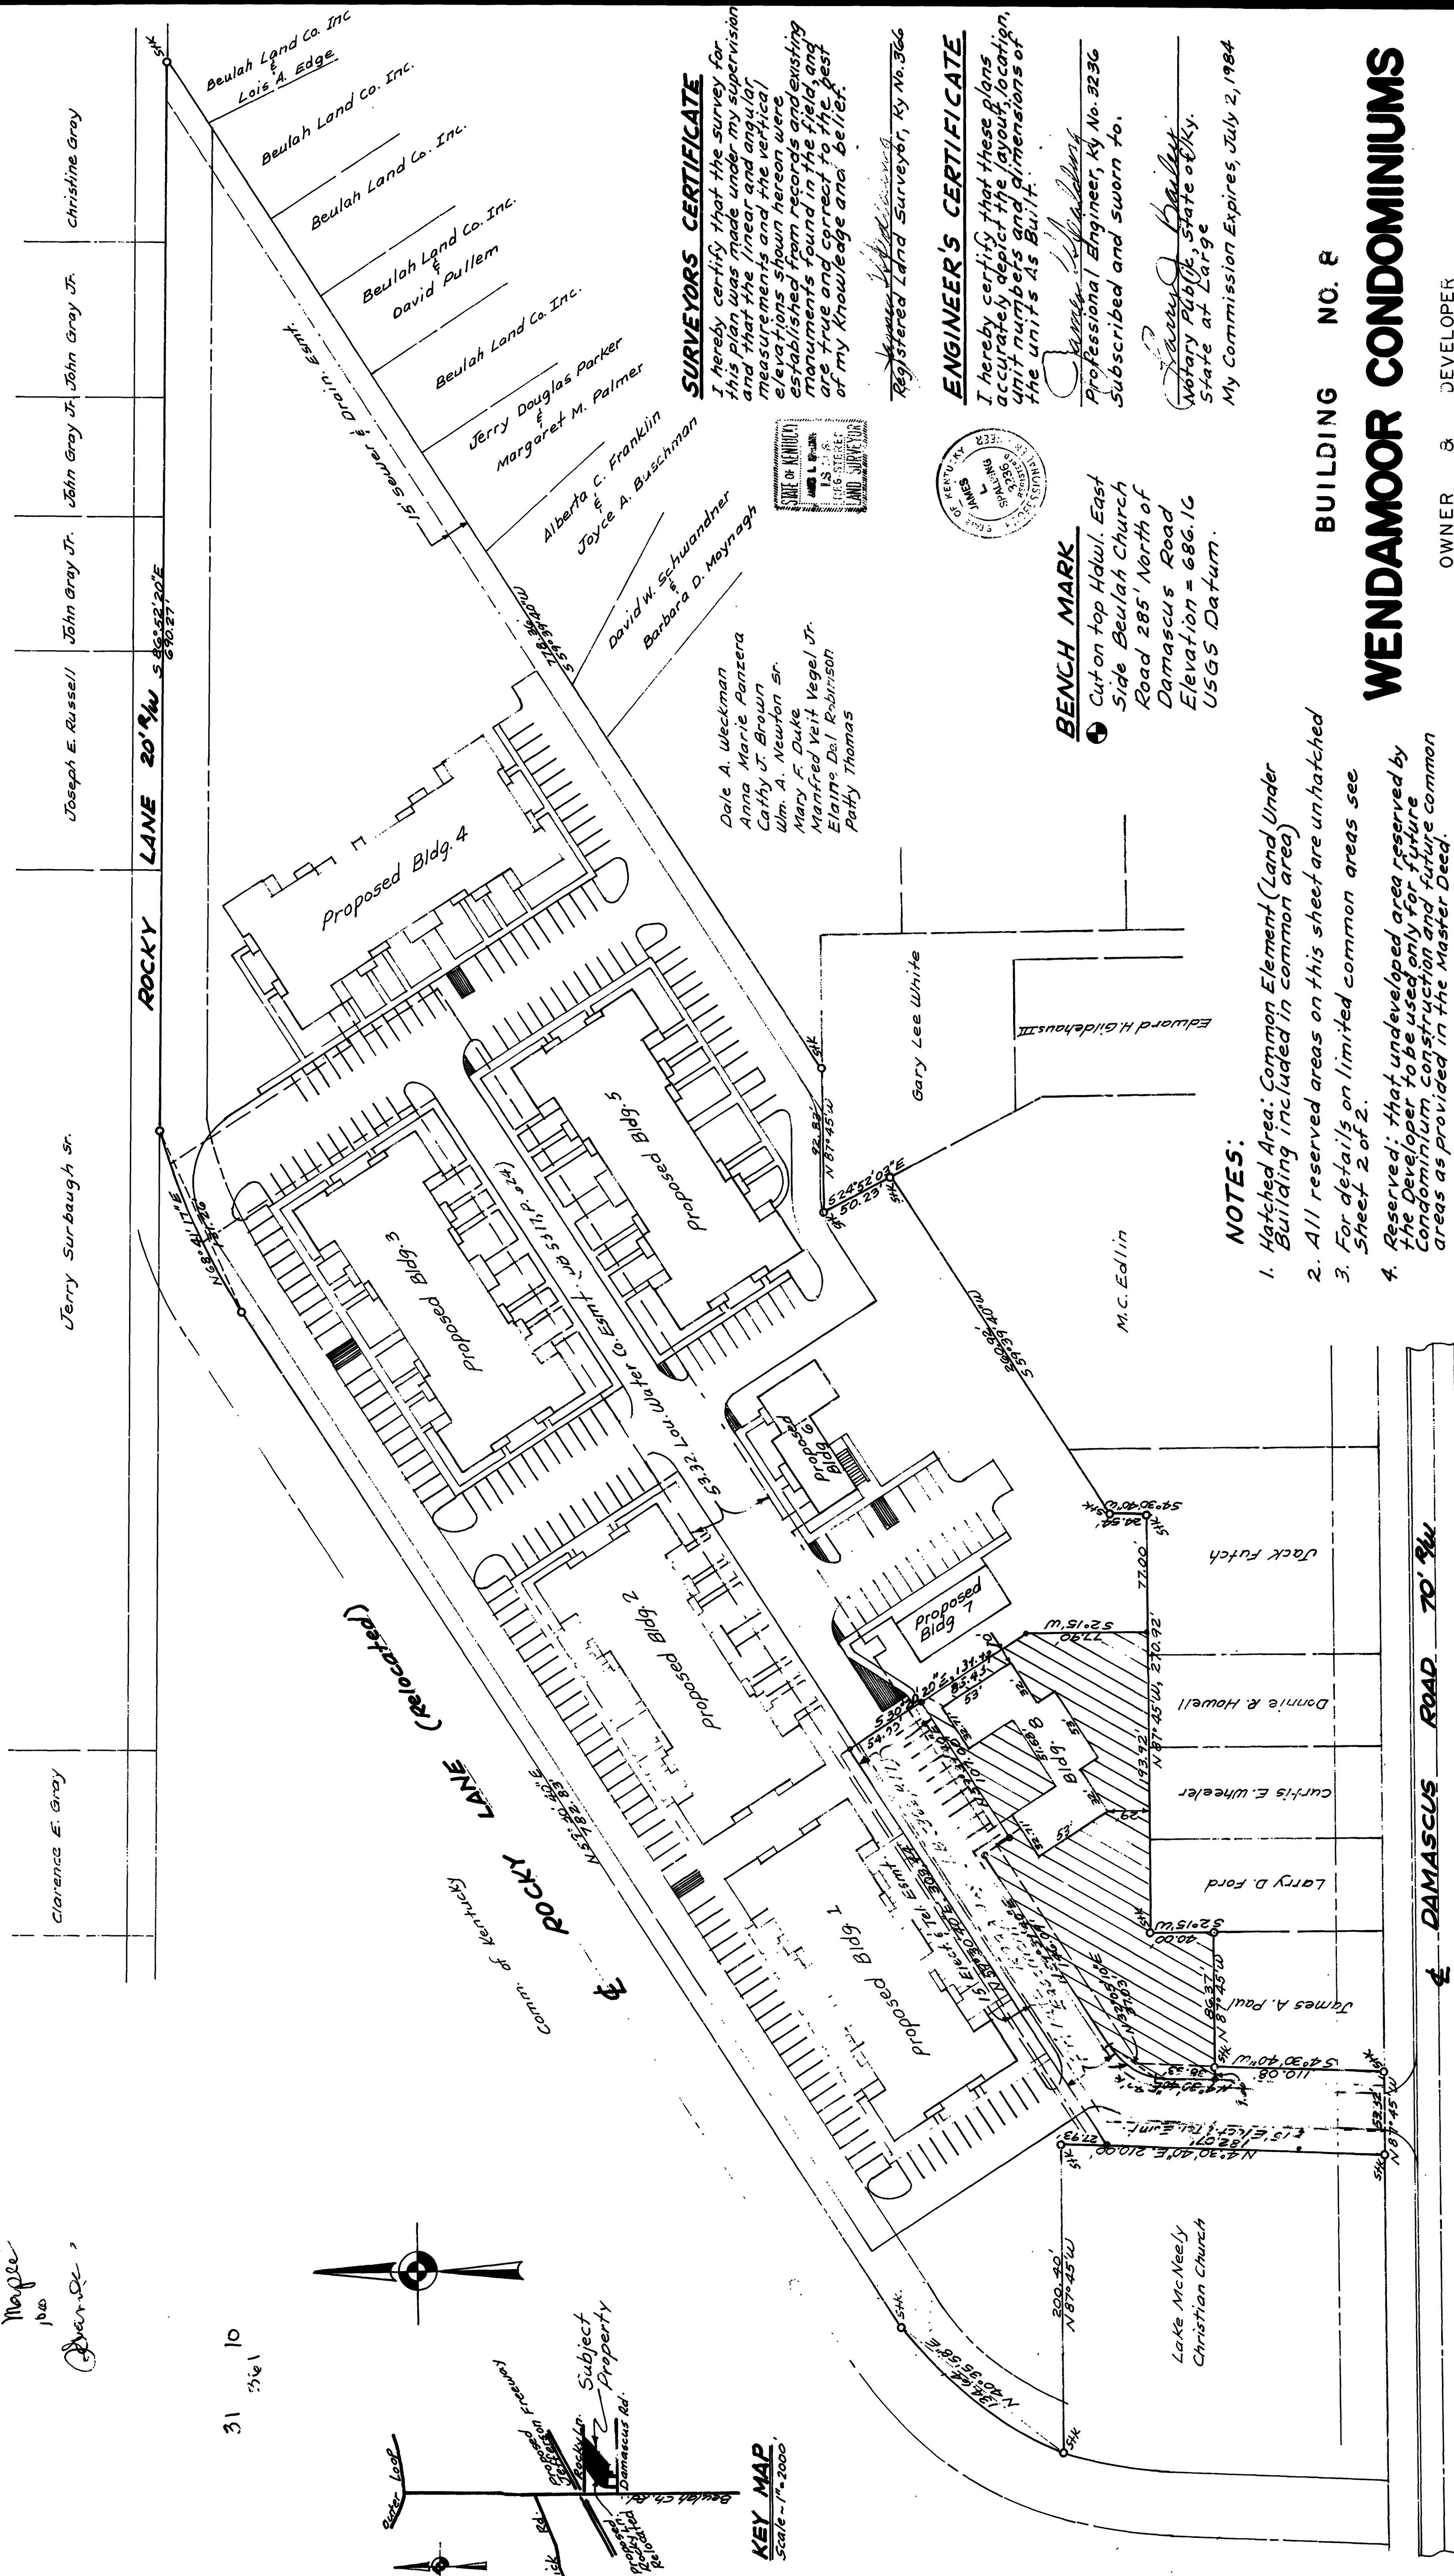

Clarence E. Gray
Joseph E. Russell
John Gray Jr.
John Gray Jr.
John Gray Jr.
Christine Gray

Jerry Surbaugh Sr.
ROCKY LANE
LANE 20' 9/16" S 89° 58' 20"E 680.27'

Beulah Land Co. Inc.
Lois A. Edge
Beulah Land Co. Inc.
Beulah Land Co. Inc.
Beulah Land Co. Inc.
David Pullen
Beulah Land Co. Inc.
Jerry Douglas Parker
Margaret M. Palmer
Beulah Land Co. Inc.
Alberto C. Franklin
Joyce A. Buschman
David W. Schwandner
Barbara D. Maymogh

Proposed Bldg 1
Proposed Bldg 2
Proposed Bldg 3
Proposed Bldg 4
Proposed Bldg 5
Proposed Bldg 6

Rocky Lane
Common of Kentucky
DAMASCUS ROAD 70' 9/16"

Lake McNeely Christian Church
James A. Paul
Larry D. Ford
Curtis E. Wheeler
Donnie R. Howell
Jack Futch
M.C. Edlin
Gary Lee White
Edward H. Gildenhaupt

DALE A. WECKMAN
ANNA MARIE PANZERA
CATHY J. BROWN
WIM A. NEWTON SR.
MARY F. DUKE
MARRIED VEIT VEGEL JR.
EATRIPS DEL ROBRISON
PATRY THOMAS

DAVID W. SCHWANDNER
BARBARA D. MAYMOGH

BEULAH LAND CO. INC.
JERRY DOUGLAS PARKER
MARGARET M. PALMER
ALBERTO C. FRANKLIN
JOYCE A. BUSCHMAN

SURVEYORS CERTIFICATE
I hereby certify that the survey for this plan was made under my supervision and that the linear and angular measurements and the vertical elevations shown hereon were established from records and existing monuments found in the field, and are true and correct to the best of my knowledge and belief.

ENGINEER'S CERTIFICATE
I hereby certify that these plans accurately depict the layout, location, dimensions and dimensions of the units as built.

NOTES:
1. Hatched Area: Common Element (Land Under Building included in common area)
2. All reserved areas on this sheet are unhatched
3. For details on limited common areas see Sheet 2 of 2.
4. Reserved: that undeveloped area reserved by the Developer to be used only for future Condominium construction and future common areas as provided in the Master Deed.

BENCH MARK
Cut on top of Hwy. East Side Beulah Church Road 285' North of Damascus Road Elevation = 686.16 USGS Datum.

KEY MAP
Scale - 1" = 2000'

OWNER & DEVELOPER
J & F Construction & Development Company
7813 GLASER ROAD
LOUISVILLE, KY. 40291

REGISTERED LAND SURVEYOR, KY No. 366
Professional Engineer, KY No. 2236
Subscribed and sworn to.
Notary Public, State of Ky.
My Commission Expires, July 2, 1984

OWNER & DEVELOPER
J & F Construction & Development Company
7813 GLASER ROAD
LOUISVILLE, KY. 40291



JAMES L. SPALDING C.E.
2143 BUECHEL BANK RD.
LOUISVILLE, KY. 40218

June 27, 1983

Sheet 1 of 2

31 10
31 10

75437
Maple
100
31
31 11

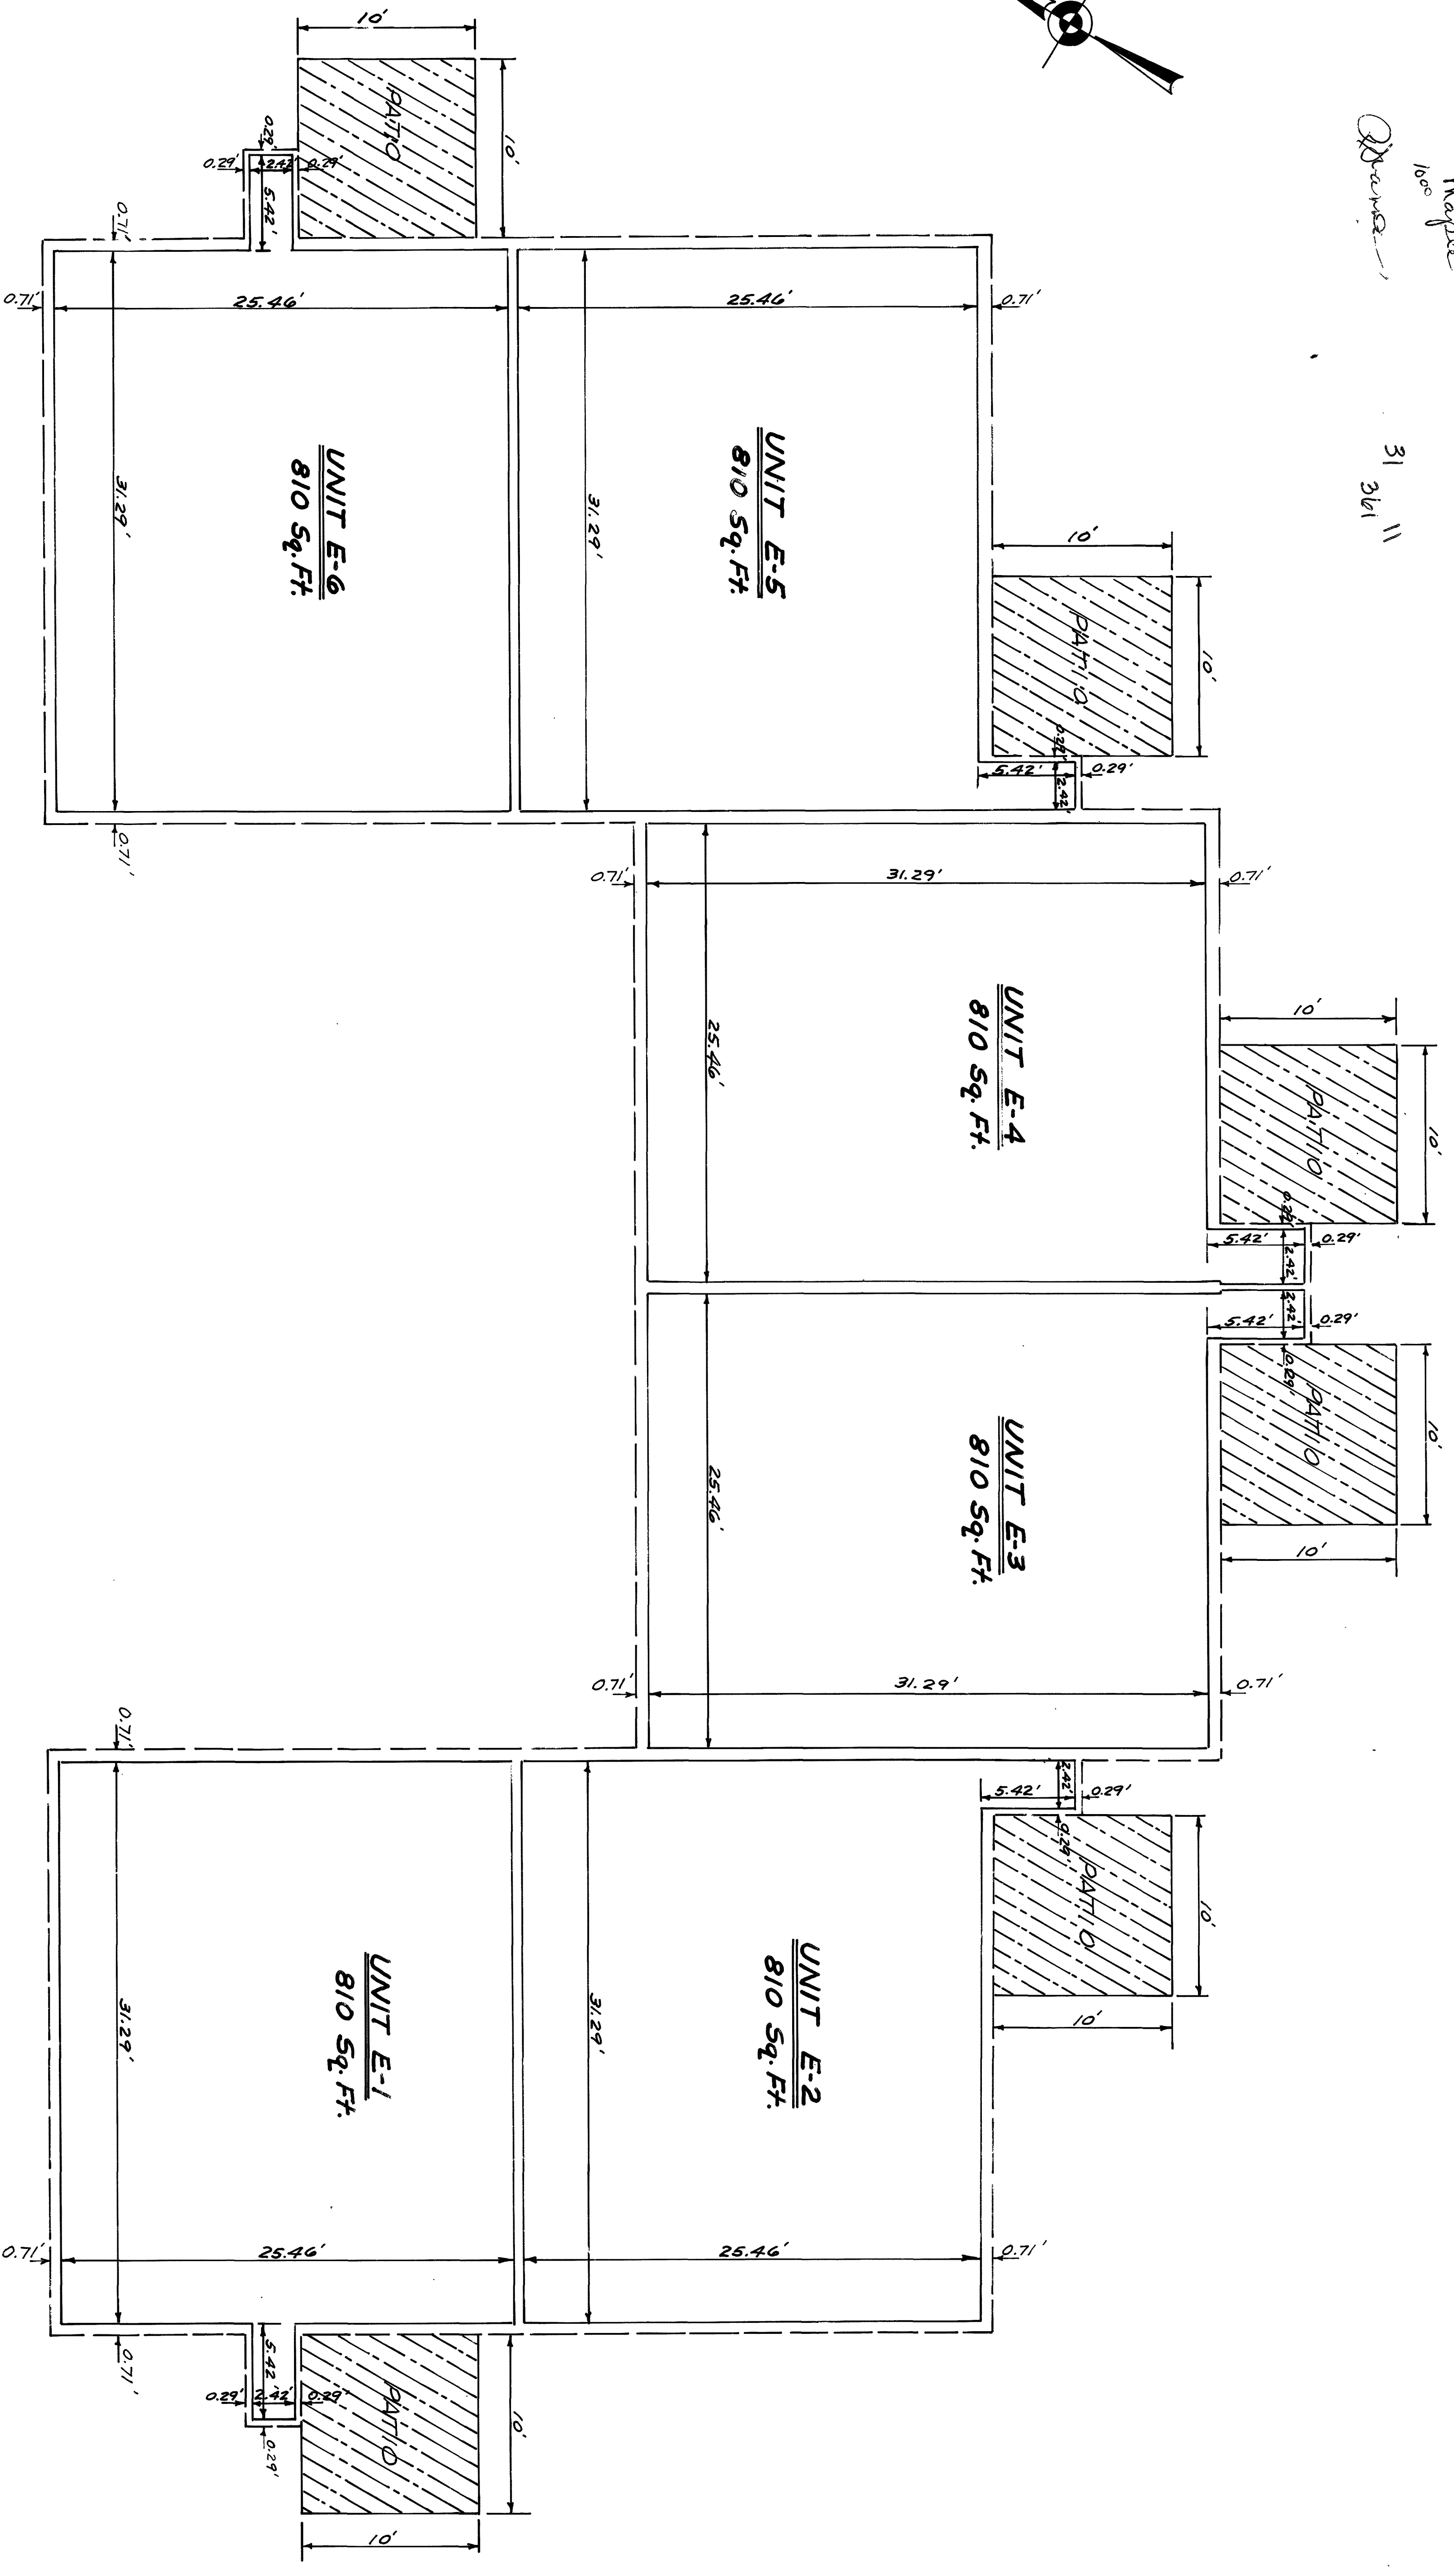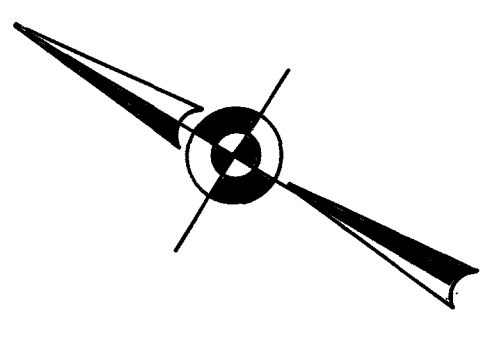

NOTES:

1. Each condominium unit consists of the space bounded by a vertical projection of the condominium unit boundary lines shown and by the horizontal planes of the floor and ceiling elevations; see notes 2 and 3 for as-built elevations.
2. Elevations shown in feet are based upon U.S. G.S. mean sea level datum for this datum.
3. All interior angles of condominium units are 90°.
4. Legend:
 - Boundary of condominium unit's
 - Indicates common elements.
 - Indicates limited common area.

5. Condominium units have the following Elevations:


Unit No.	Floor Elev.	Ceiling Elev.
E-1	692.40	700.48
E-2	692.40	700.48
E-3	692.40	700.48
E-4	692.40	700.48
E-5	692.40	700.48
E-6	692.40	700.48

WENDAMOOR CONDOMINIUMS

BUILDING NO. 8

OWNER & DEVELOPER
J & F Construction & Development Company
7813 GLASER ROAD
LOUISVILLE, KY. 40291

JAMES L. SPALDING C.E.
2143 BUECHEL BANK RD.
LOUISVILLE, KY. 40218

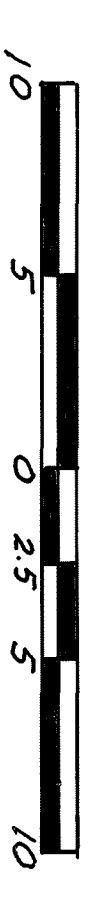

June 27, 1983

Sheet 2 of 2

31x11