

KEY MAP

SURVEYOR'S CERTIFICATE

I HEREBY CERTIFY THAT THE SURVEY FOR THIS PLAN WAS MADE UNDER MY SUPERVISION AND THAT THE LINEAR AND ANGULAR MEASUREMENTS AND THE VERTICAL ELEVATIONS SHOWN HEREON WERE ESTABLISHED FROM RECORDS AND EXISTING MONUMENTS FOUND IN THE FIELD, AND ARE TRUE AND CORRECT TO THE BEST OF MY KNOWLEDGE AND BELIEF.

Scott J. Hines
REGISTERED LAND SURVEYOR, KY. 2089

ENGINEER'S CERTIFICATE

I HEREBY CERTIFY THAT THESE PLANS ACCURATELY DEPICT THE LAYOUT, LOCATION, UNIT NUMBERS AND DIMENSIONS OF THE UNITS AS BUILT. SUBSCRIBED AND SWORN TO,

David R. Cox
PROFESSIONAL ENGINEER, KY. 10413

David R. Cox
NOTARY PUBLIC, STATE OF KY., COUNTY -
AT-LARGE, MY COMMISSION EXPIRES
May 20, 1985

NOTE:
EXISTING BUILDINGS HAVE BEEN RECORDED IN "APARTMENT OWNERSHIP BOOKS" AS FOLLOWS:

BUILDING	BOOK	PAGE
A	20	44
B	21	37
C	22	27

BENCH MARK

BM NO. 1 EX. M.H. RIM STA. 32+26.17
BROOKHAVEN SECTION "F" SAN-ITARY SEWERS.
ELEV. 561.33

OAKVIEW JOINT VENTURE

BY: COX, R. PEMBERTON, INC.

BY: PRESIDENT

BY: L. H. F. SERVICE CORPORATION

BY: PRESIDENT


ACKNOWLEDGMENT:

STATE OF KENTUCKY
COUNTY OF JEFFERSON

THIS FOREGOING PLAT WAS ACKNOWLEDGED BEFORE ME THIS 13th DAY OF August 1984, BY OAKVIEW JOINT VENTURE BY COX & PEMBERTON, INC. BY CARL R. COX AS PRESIDENT, AND BY L. H. F. SERVICE CORPORATION BY TERRY A. TURBEVILLE AS PRESIDENT, TO BE THE ACT AND DEED OF OAKVIEW JOINT VENTURE.

Scott J. Hines
NOTARY PUBLIC, JEFFERSON CO. KENTUCKY

MY COMMISSION EXPIRES

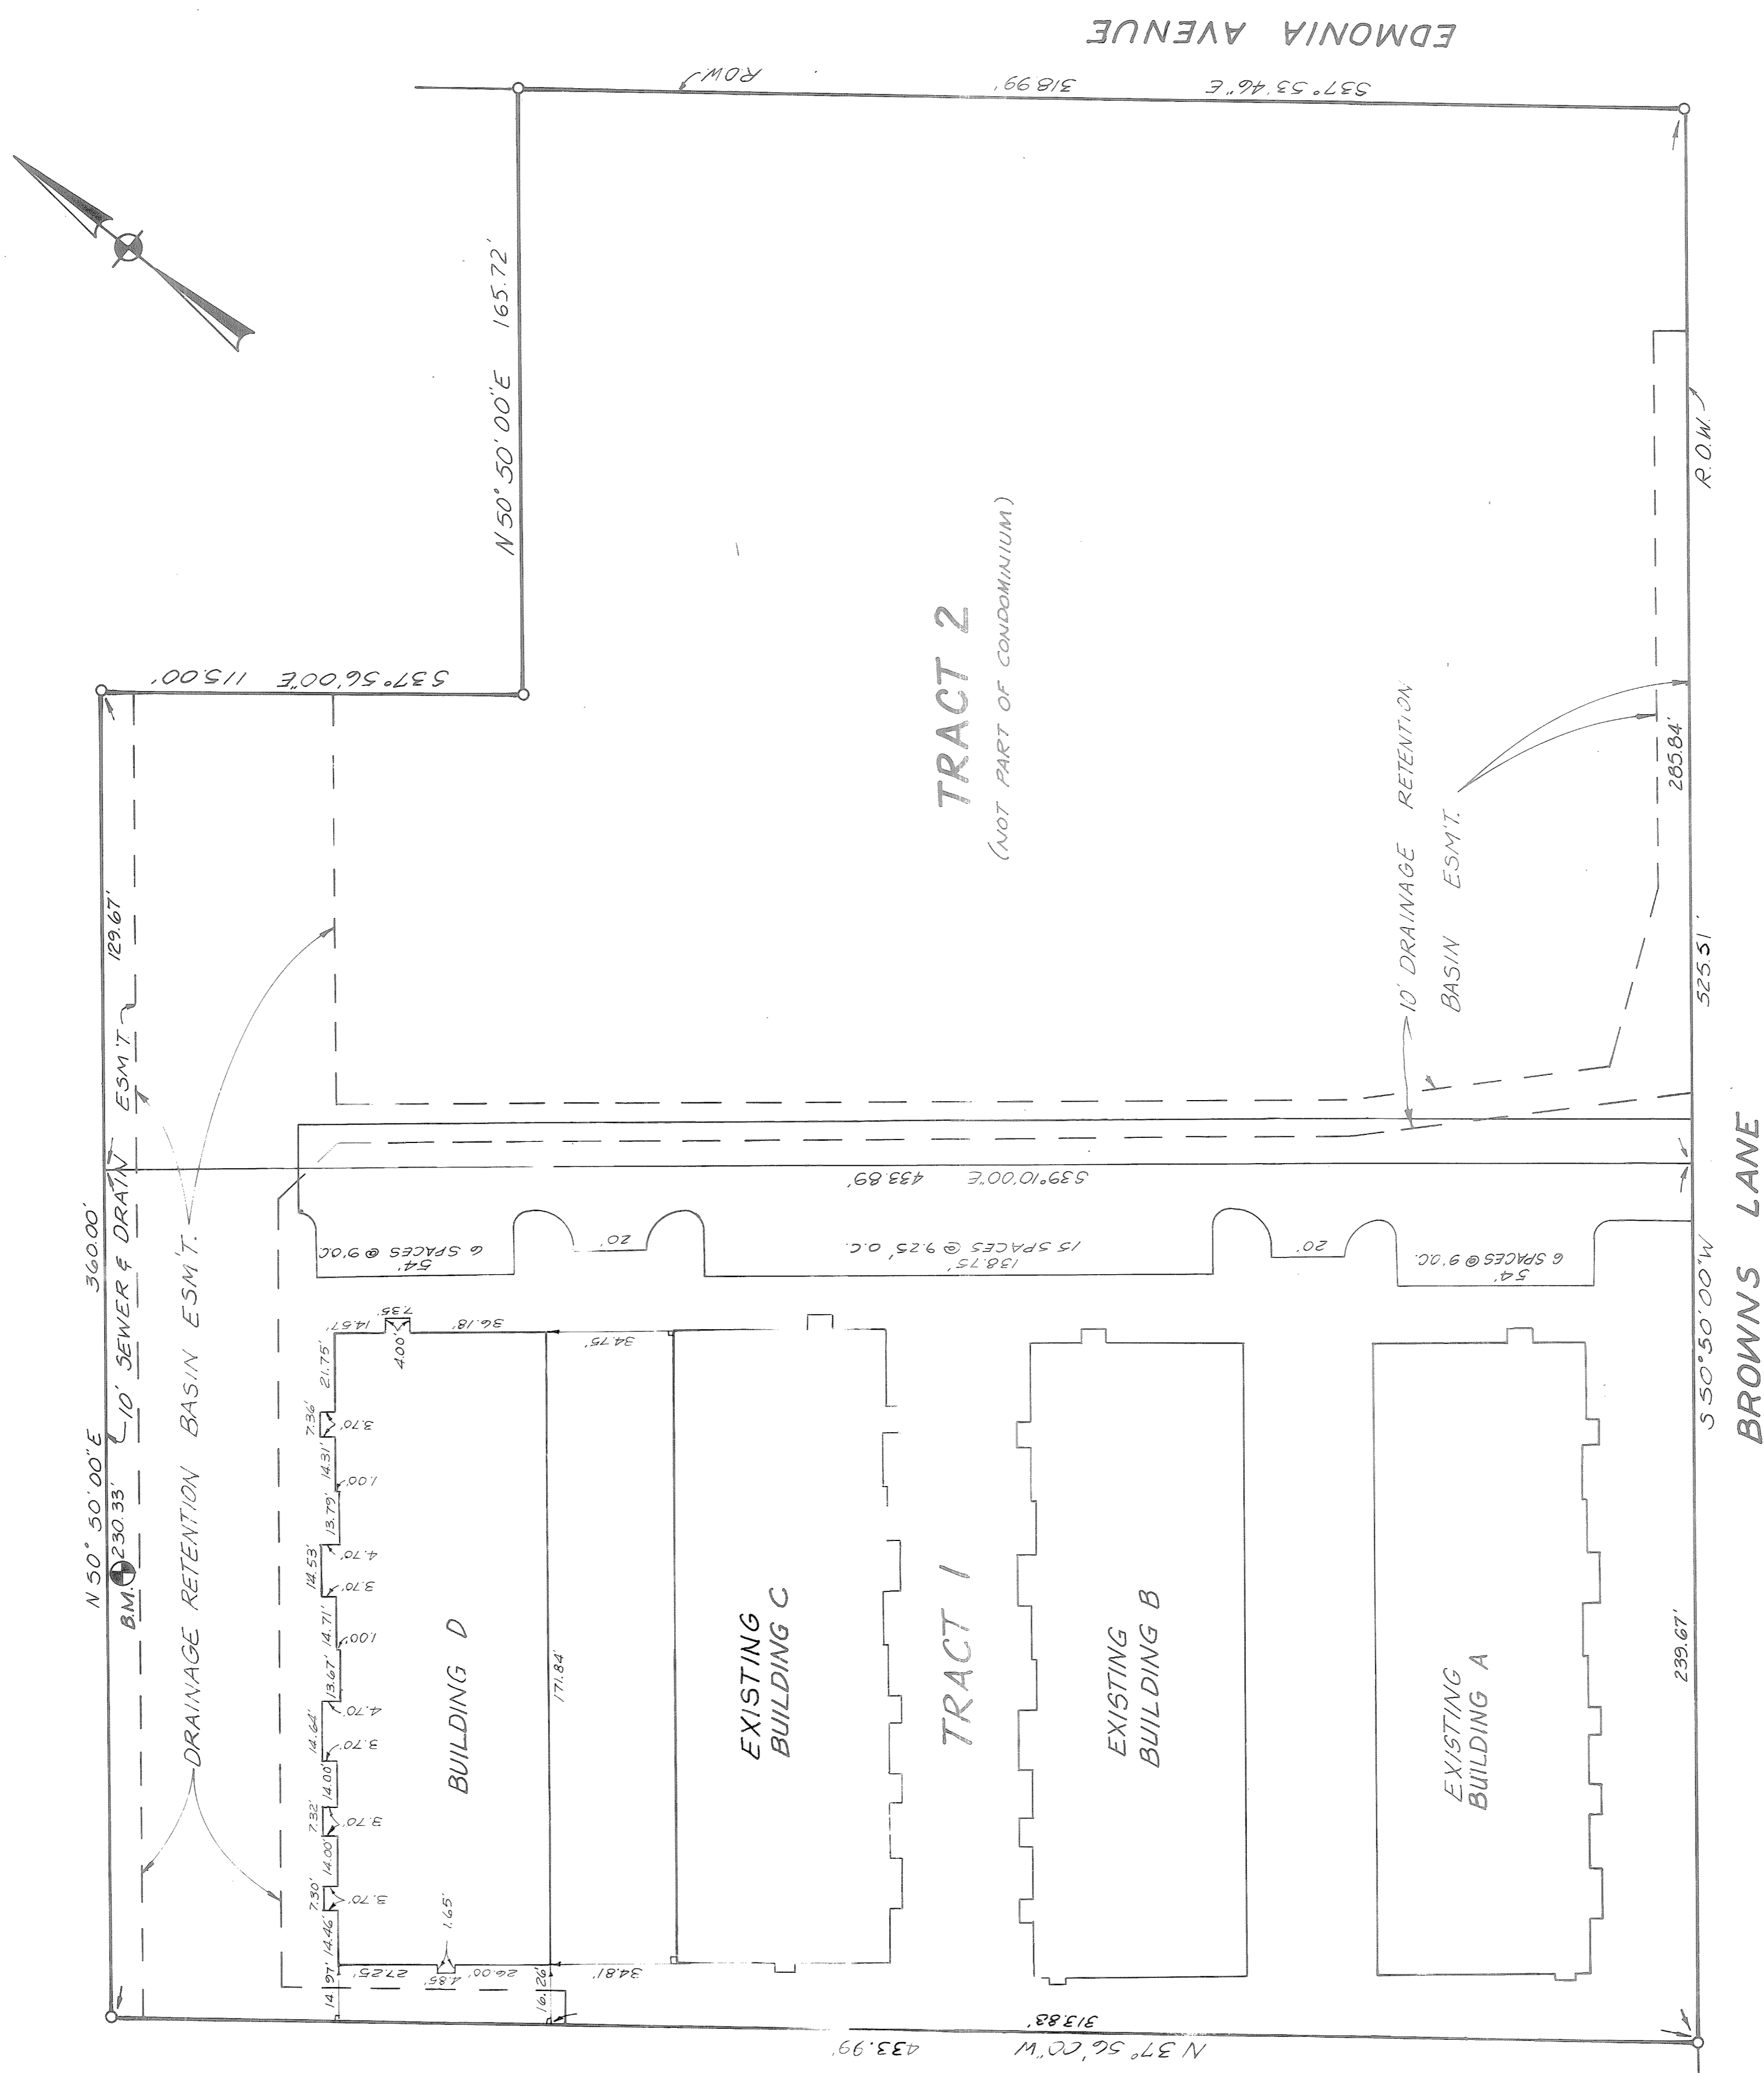

REVISIONS

SCALE
1" = 30'
DRAWN K.M.
DATE 7/8/84

SABAK, WILSON & HERP, INC.
ENGINEERS, LANDSCAPE ARCHITECTS & PLANNERS
LOUISVILLE, KENTUCKY
300 WEST MAIN


PROPERTY MAP
WOODSPOINTE TOWNHOMES
BUILDING D
Jefferson County, Kentucky

FILE 147-ADP
3 No.
Sheet 1 of 50
1


26 x 1

NOTES


- EACH CONDOMINIUM UNIT CONSISTS OF THE SPACE BOUNDED BY A VERTICAL PROJECTION OF THE CONDOMINIUM UNIT BOUNDARY LINES SHOWN AND BY THE HORIZONTAL PLANES AT THE FLOOR AND CEILING ELEVATION NOTES BELOW.
- ELEVATIONS SHOWN IN FEET ARE BASED UPON U.S.C. & G.S. MEAN LEVEL (72.00' BENCH MARK). FLOOR AND CEILING ELEVATIONS ARE REFERRED TO THIS DATUM.
- ALL INTERIOR ANGLES OF CONDOMINIUM UNITS ARE 90°.
- LEGEND:
 - BOUNDARY OF CONDOMINIUM UNITS
 - LIMITED COMMON ELEMENTS
 - INDICATES CHANGE IN ELEVATION
- CONDOMINIUM UNITS HAVE THE FOLLOWING ELEVATIONS.

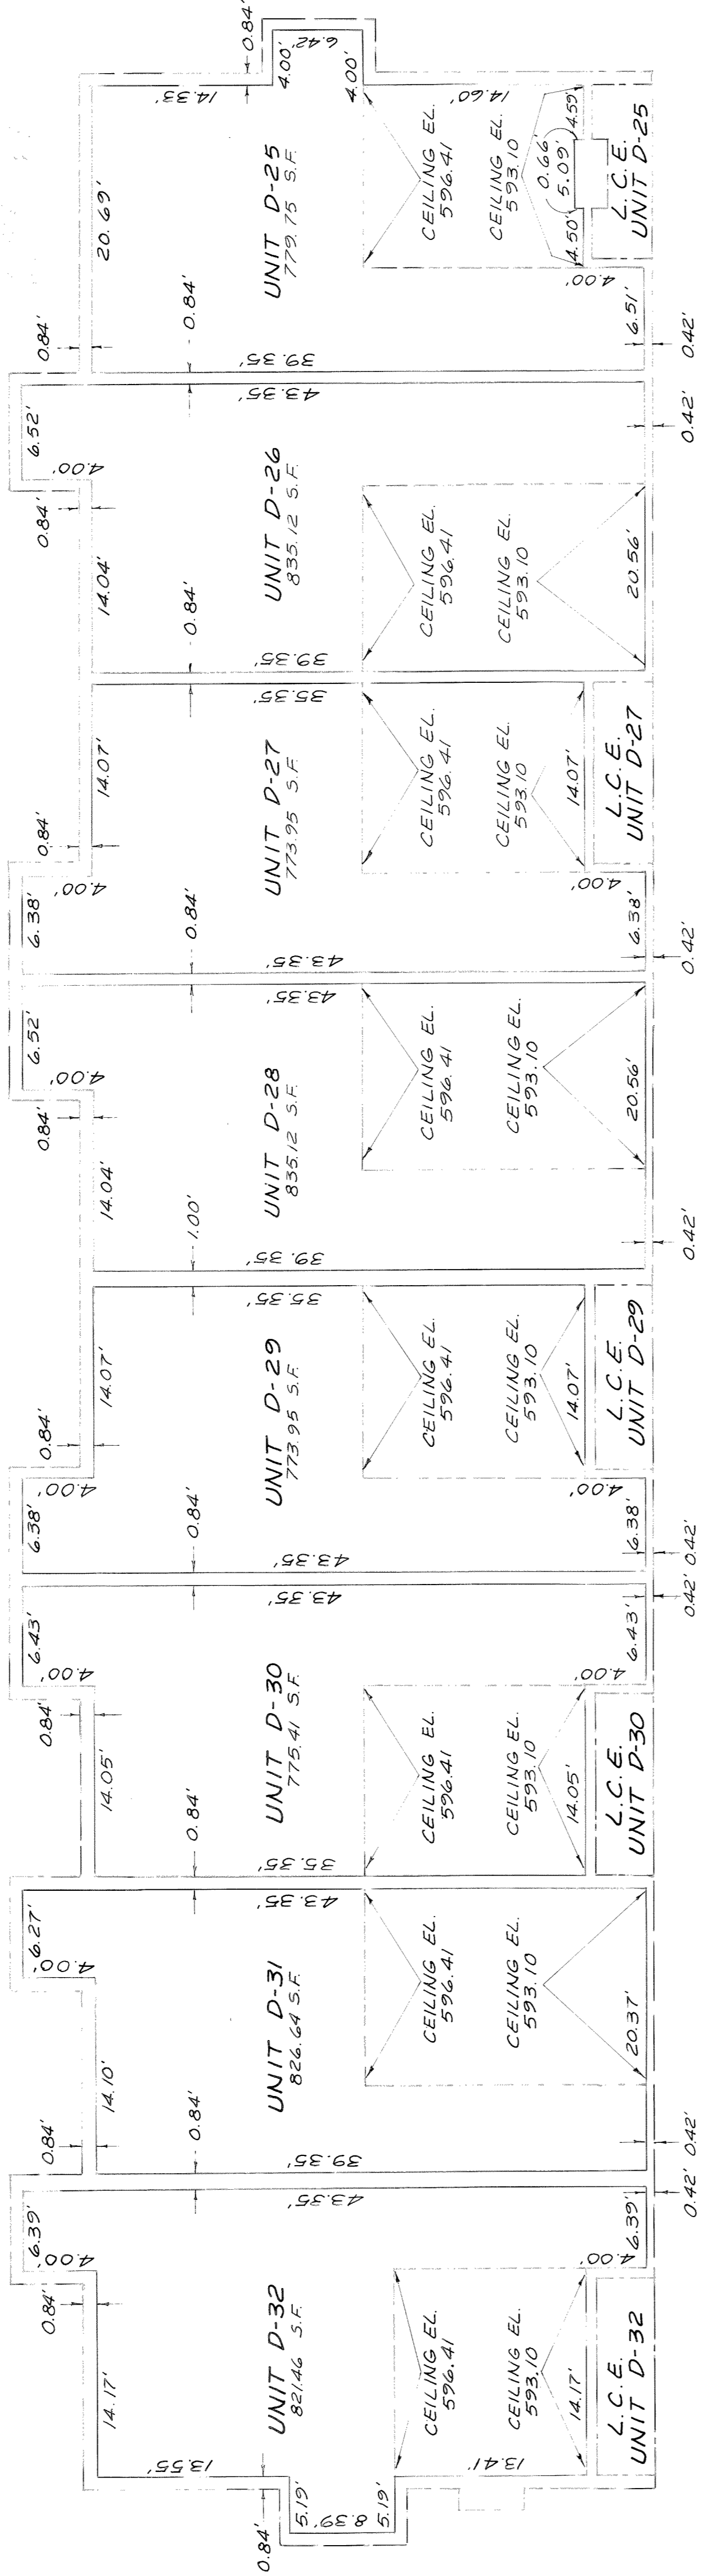

SECOND FLOOR

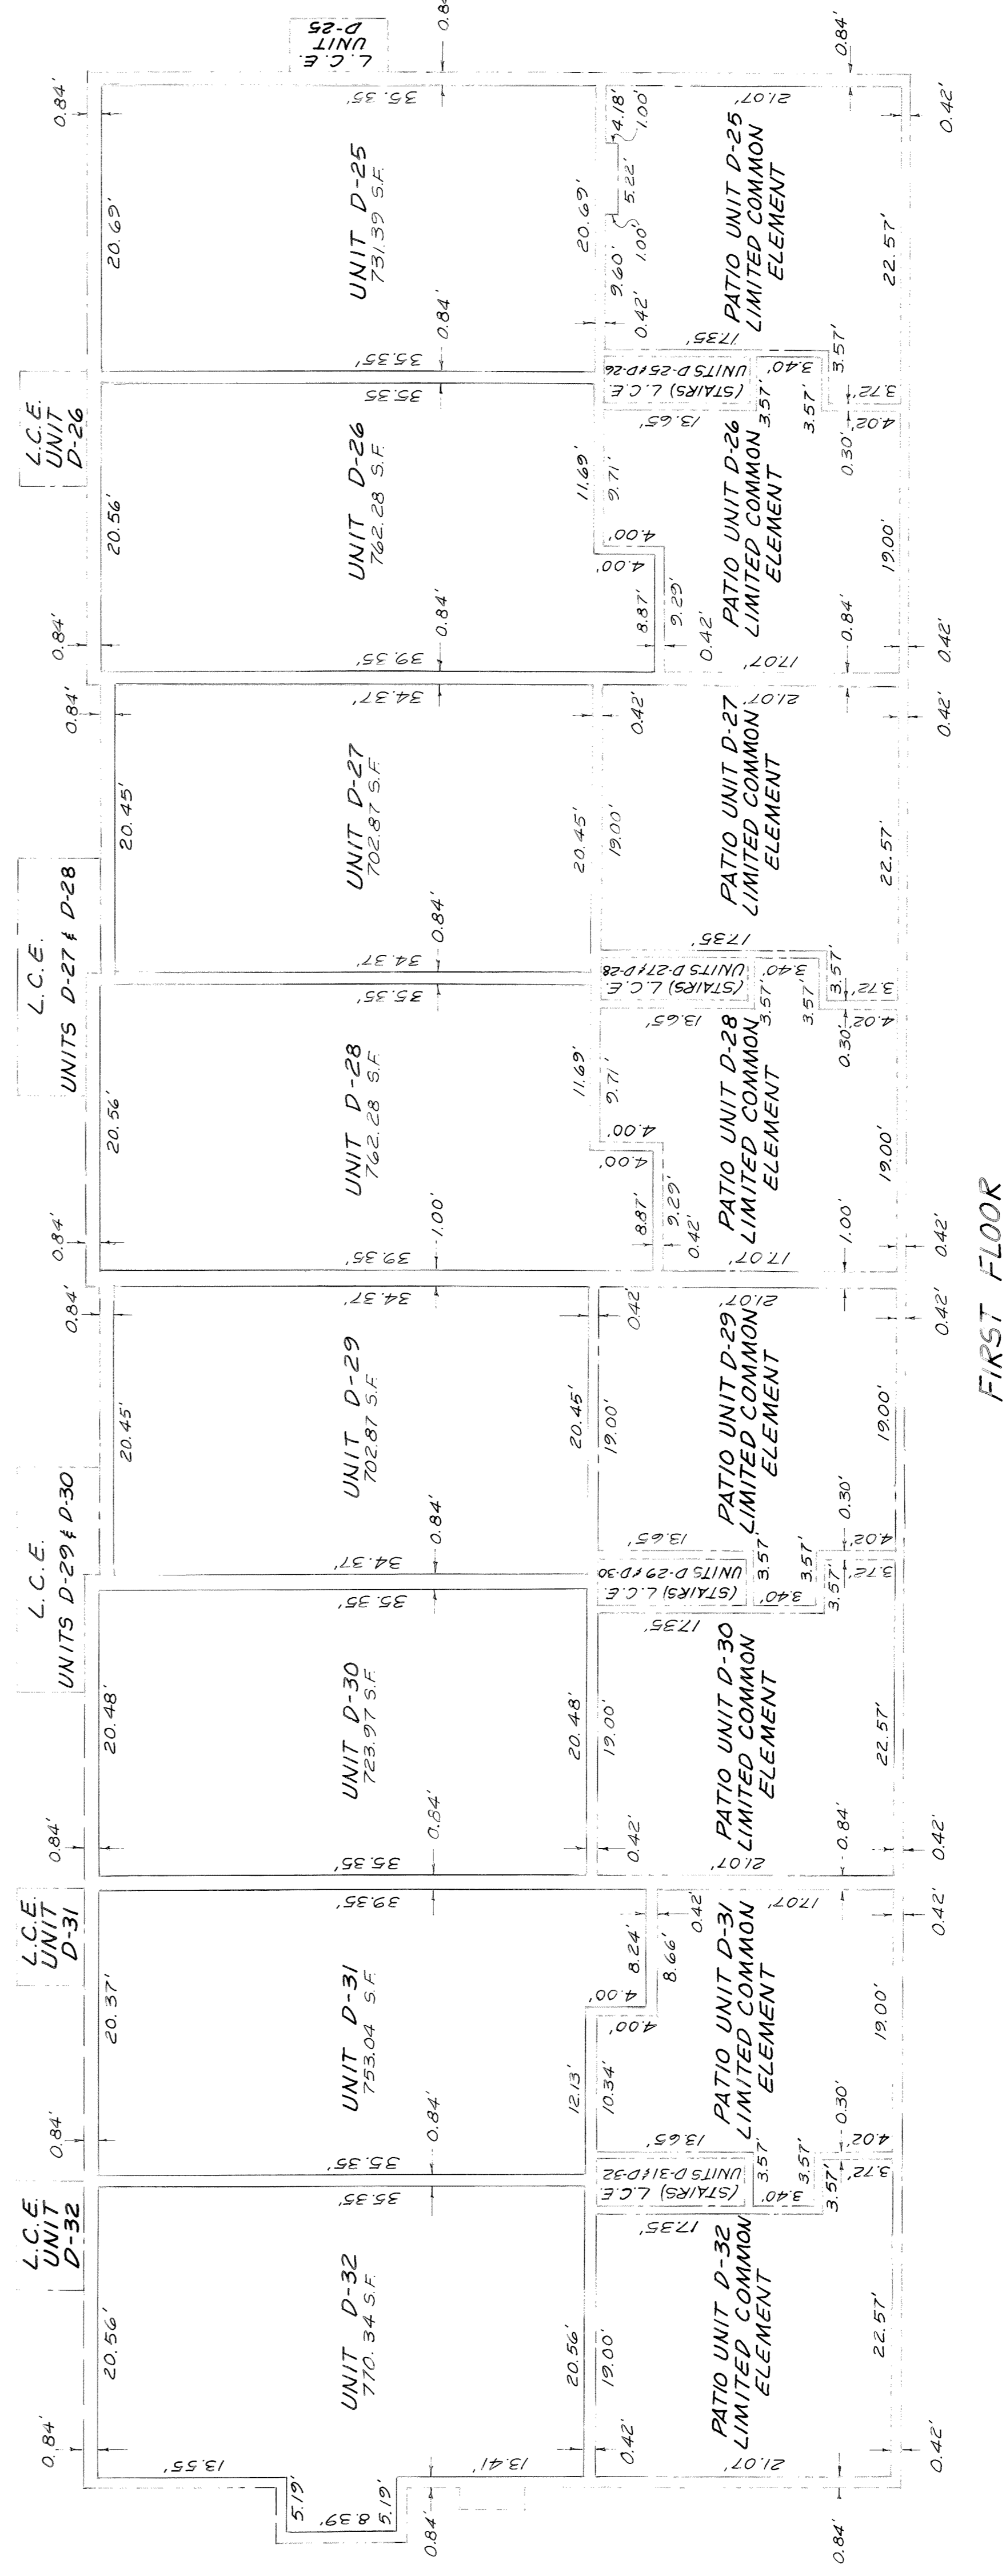

FIRST FLOOR

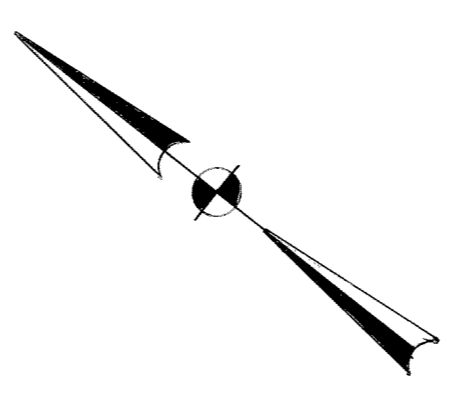

UNIT	1ST. FLOOR	1ST. CEILING	2ND FLOOR	2ND CEILING
D-25	574.67	582.67	583.57	591.57
D-26	574.67	582.67	583.57	591.57
D-27	574.67	582.67	583.57	591.57
D-28	574.67	582.67	583.57	591.57
D-29	574.67	582.67	583.57	591.57
D-30	574.67	582.67	583.57	591.57
D-31	574.67	582.67	583.57	591.57
D-32	574.67	582.67	583.57	591.57

SCALE 1/8" = 1'-0"
DRAWN BY K.M.
DATE 7-18-87

SABAK, WILSON, HEINER & LINGO, INC.
ENGINEERS, ARCHITECTS & PLANNERS
LOUISVILLE, KENTUCKY

REVISIONS

BUILDING D
WOOLSFORTE TOWNHOMES
Jefferson County, Kentucky


FILE 147-40P
3 No. 2
Sheet Set

NOTES

- EACH CONDOMINIUM UNIT CONSISTS OF THE SPACE BOUNDED BY A VERTICAL PROJECTION OF THE CONDOMINIUM UNIT BOUNDARY LINES SHOWN AND BY THE HORIZONTAL PLACES AT THE FLOOR AND CEILING ELEVATION NOTED BELOW.
- ELEVATIONS SHOWN IN FEET ARE BASED UPON U.S.C. & G.S. MEAN LEVEL DATUM - BENCH MARK, FLOOR AND CEILING ELEVATIONS ARE REFERRED TO THIS DATUM.
- ALL INTERIOR ANGLES OF CONDOMINIUM UNITS ARE 90°.
- LEGEND:
 - BOUNDARY OF CONDOMINIUM UNITS
 - INDICATES LIMITED COMMON ELEMENTS
 - INDICATES COMMON ELEMENTS
 - INDICATES CHANGE IN ELEVATION
- CONDOMINIUM UNITS HAVE THE FOLLOWING ELEVATIONS:

UNIT	GARAGE F.F.	GARAGE CEILING	BSM'T. F.	BSM'T. CEILING
D-25	565.47	573.47	565.77	573.77
D-26	565.47	573.47	565.77	573.77
D-27	565.47	573.47	565.77	573.77
D-28	565.47	573.47	565.77	573.77
D-29	565.47	573.47	565.77	573.77
D-30	565.47	573.47	565.77	573.77
D-31	565.47	573.47	565.77	573.77
D-32	565.47	573.47	565.77	573.77

6. GARAGE AREA SHOWN ON THIS SHEET IS INCLUDED IN THE UNIT BASEMENT SQUARE FOOTAGE.

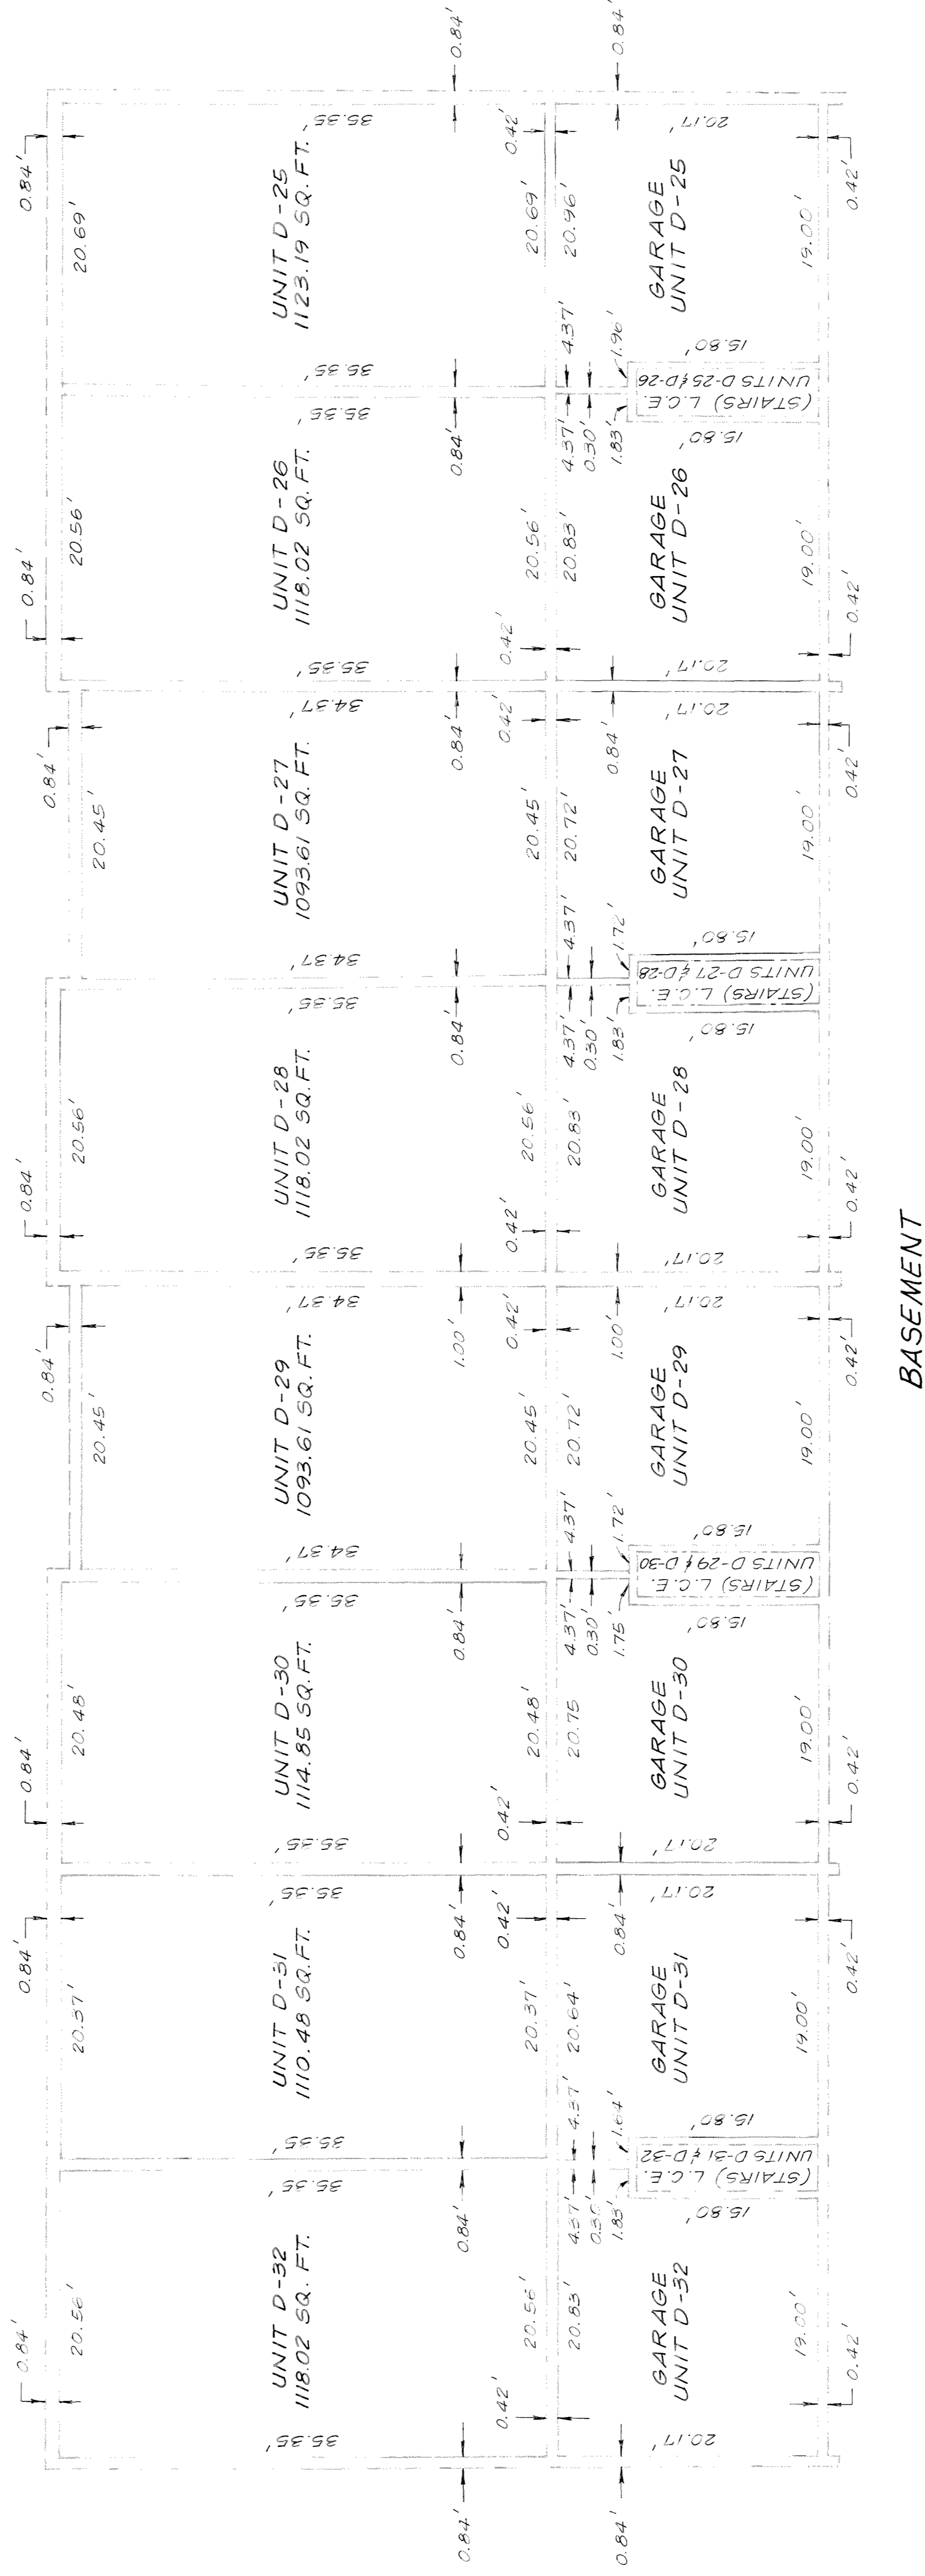

SCALE: 1" = 8'
DRAWN: K.M.
DATE: 7-18-81

SABAK, WILSON, HEINER & LINGO, INC.
ENGINEERS, LANDSCAPE ARCHITECTS & PLANNERS
NASHVILLE, TENNESSEE

REVISIONS

BUILDING D
WOODSPRINGS TOWNHOMES
Jefferson County, Kentucky

FILE 147-ADP
3 Sheets of 38

26 x 3